


RECORDED WITHIN SOUTH, 1953, AT 1:58 P.M. #7095

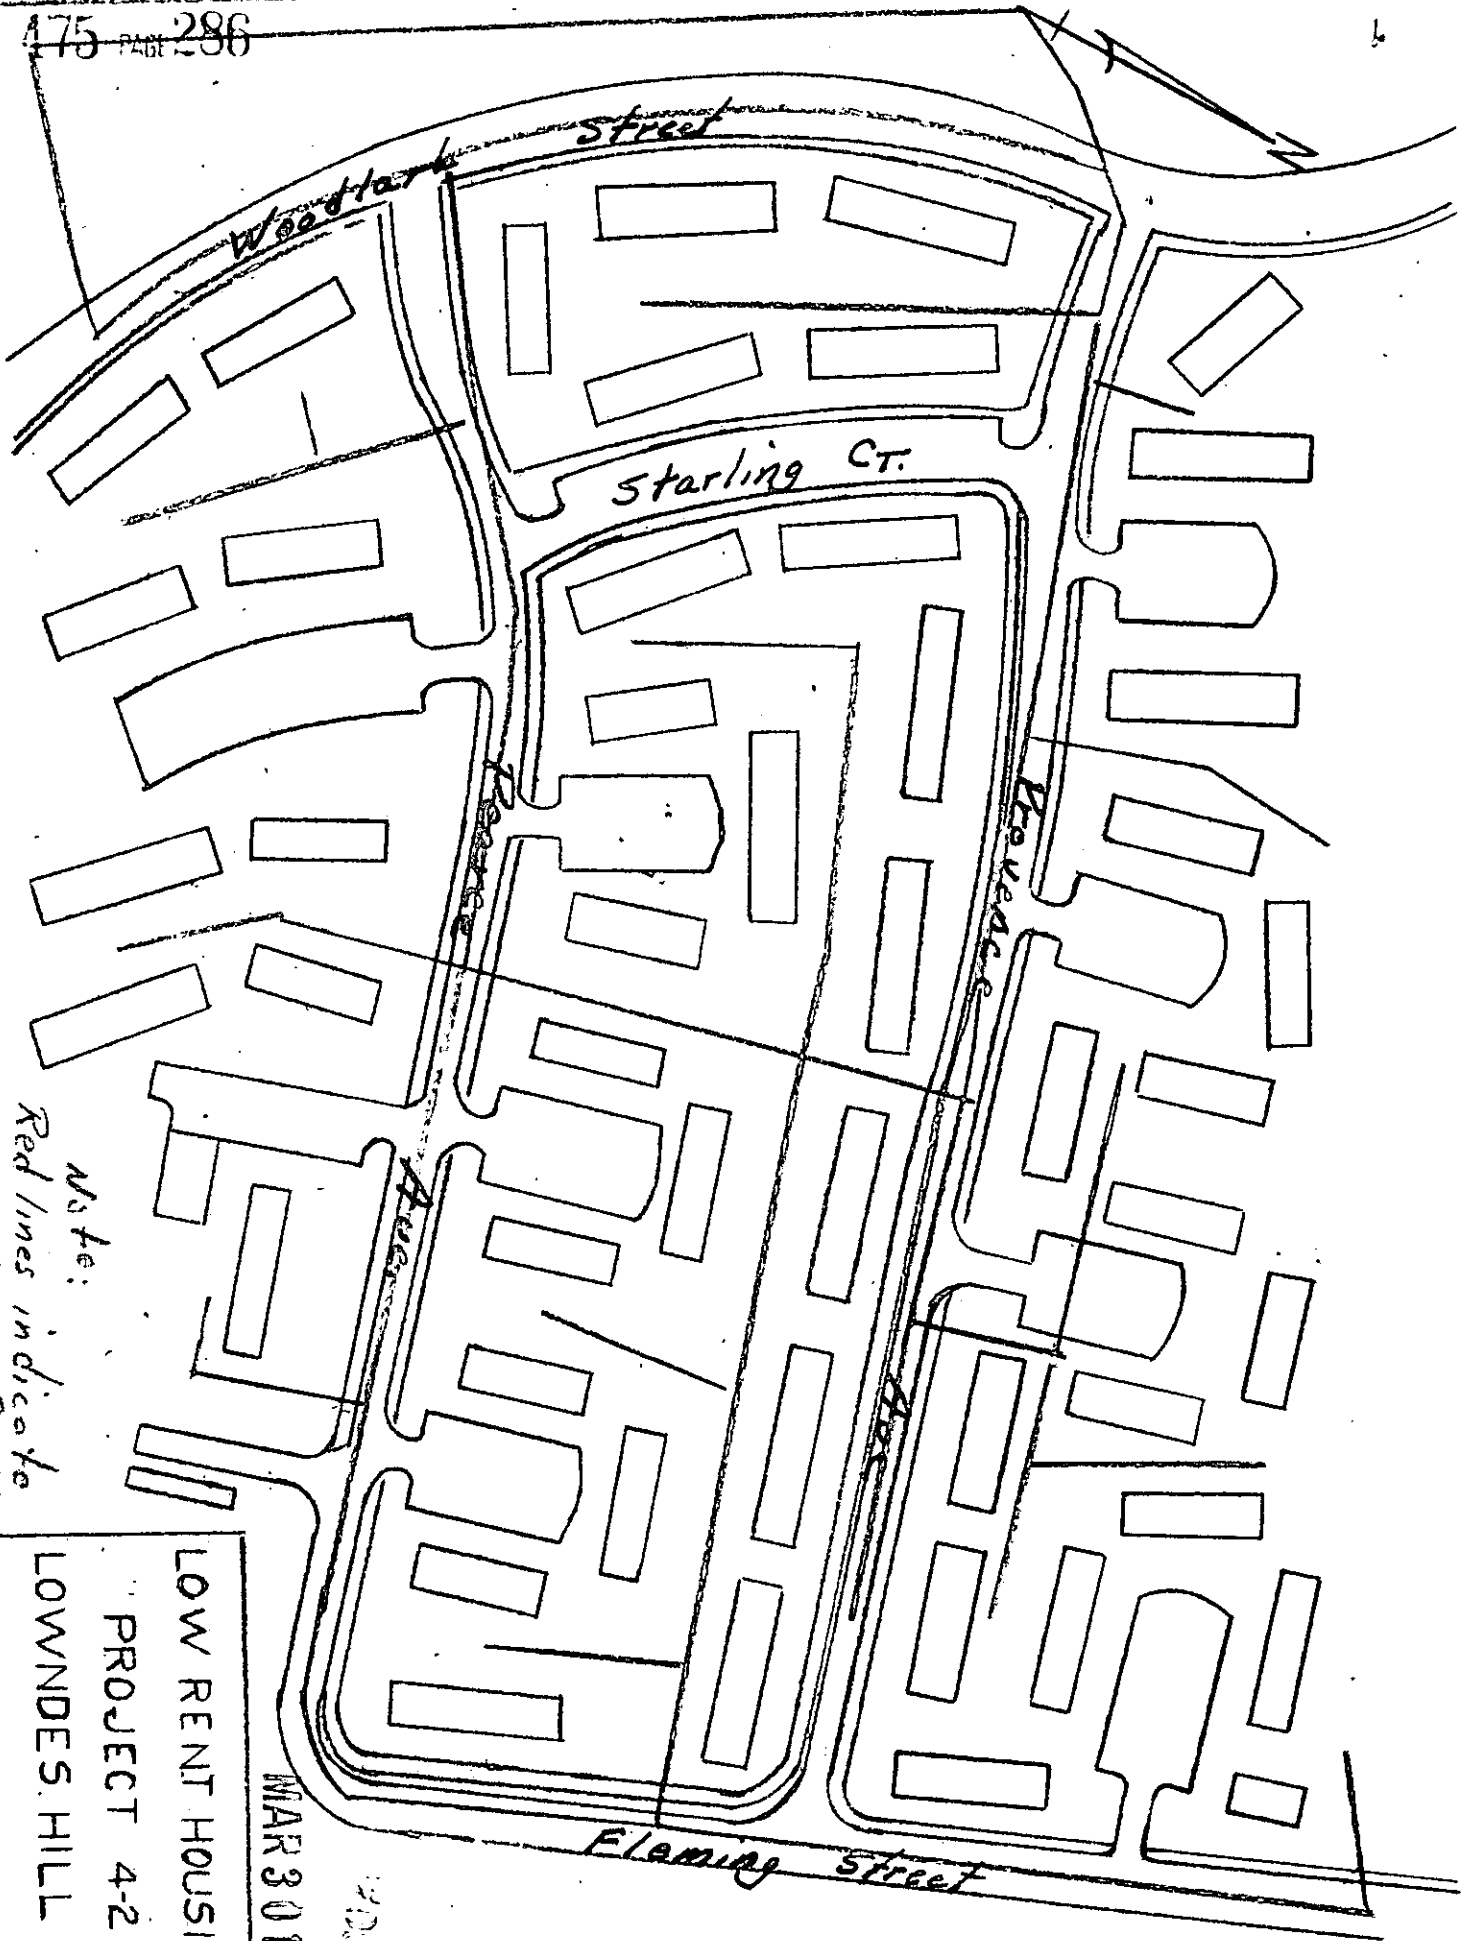

Note:
 Red lines indicate
 Duke Power Co. Lines

LOW RENT HOUSING
 PROJECT 4-2
 LOWNDES HILL RD.

MAR 30 1953

For Easement in connection with this Plat See Deed Book 475 Page 285