



PETTIGRU ST.

1213-514

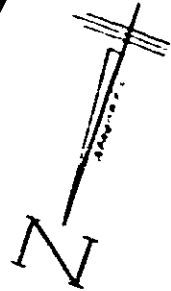

10' ALLEY (Asps + Piers)

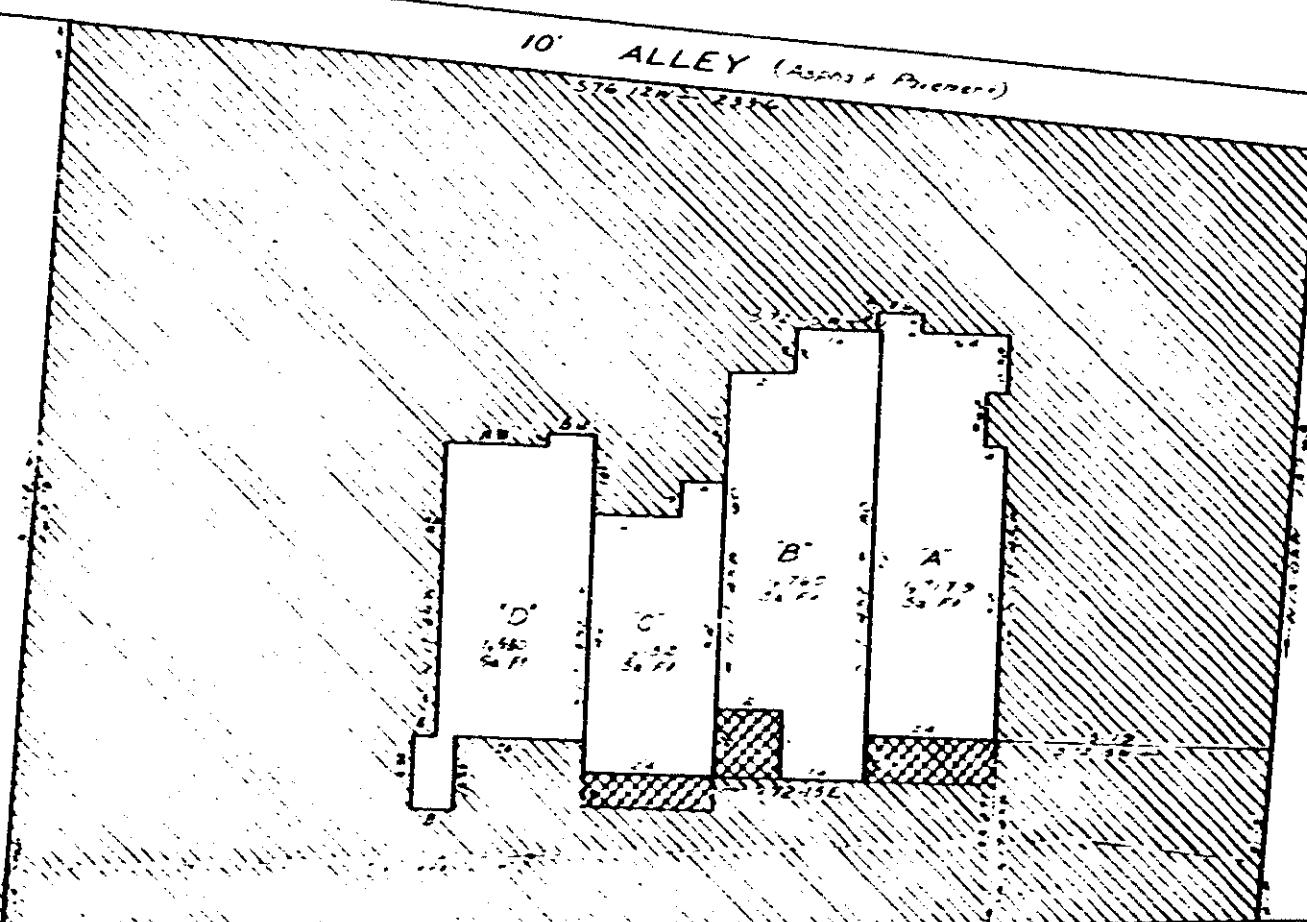

EAST NORTH STREET RAMP

Area 35,202 Sq Ft = 0.81 Acre

AS BUILT SURVEY

FOR

JAMES D. MILLER

GREENVILLE, SC


JULY, 1983  
Revised 11/22/1984

General Common Elements  
Leased Common Elements

CONTINUED ON NEXT PAGE



W. WILLIAMS, JR.  
ENGINEER/SURVEYOR, INC.  
P.E. License No. 2079  
15 S. MAIN STREET  
TRAVELERS REST, S.C.  
29690

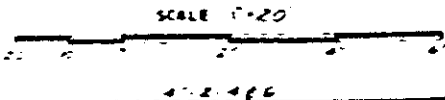

W. Williams, Jr.  
PER 11/14/84

5039

9 5 1 2

1325-172