


FILED
GR GREENVILLE CO. S. C.

WASHINGTON PLACE
WATER FURNACE IN. ST. ROW 311-28 AM '77

~~DONNIE S. TANKERSLEY~~
~~R.M.C.~~

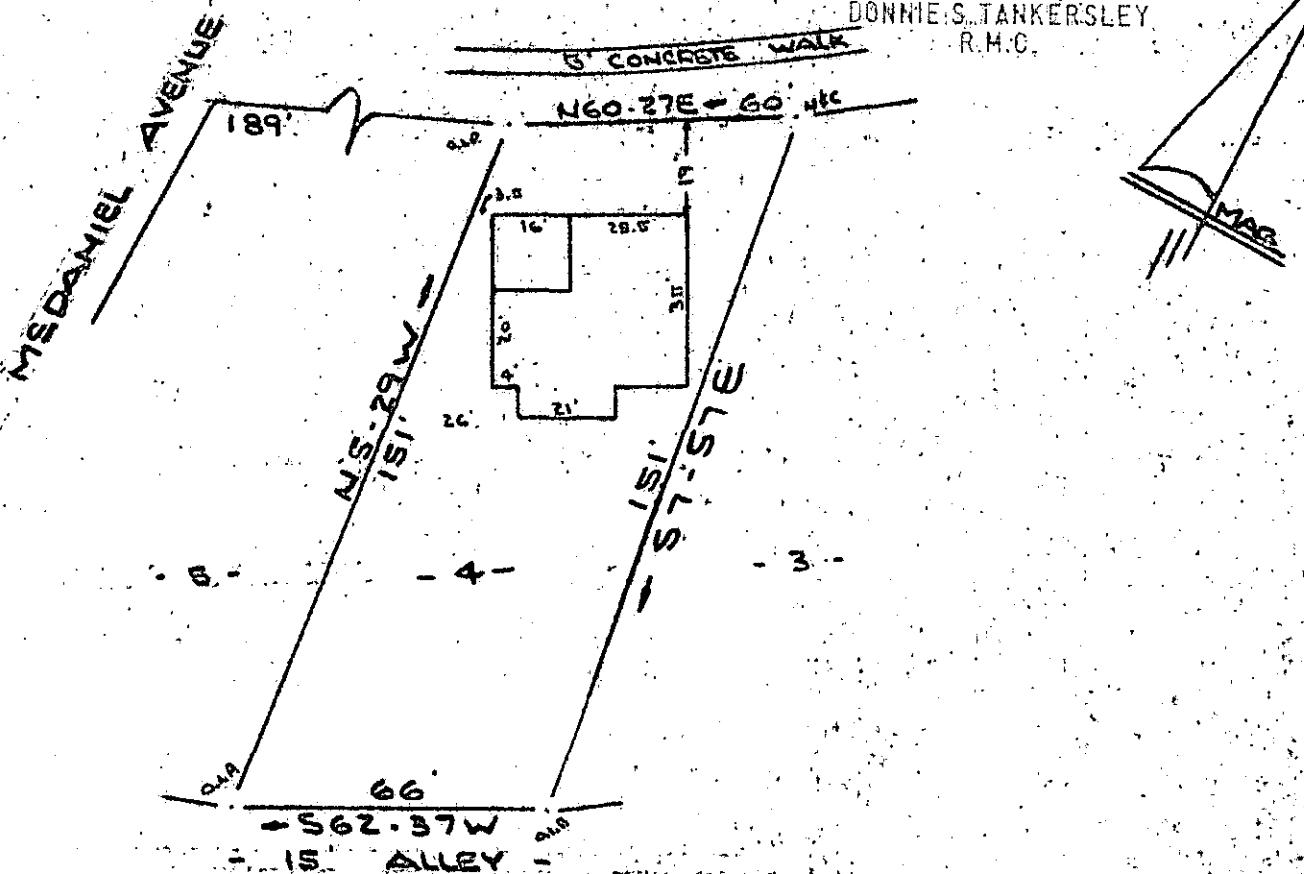

SURVEY FOR
W. DANIEL YARBOROUGH, JR.
GEORGE N. FUNDERBURK
DAVID W. GLENN
GREENVILLE, SOUTH CAROLINA
SCALE 1:40
9MAY1977

MICROFILMED

JUN 3 1977

33551

4.1.75 JUN 1
CAROLINA SURVEYING CO.
112 MANLY ST.
GREENVILLE, S.C.

1005A

• 11700