
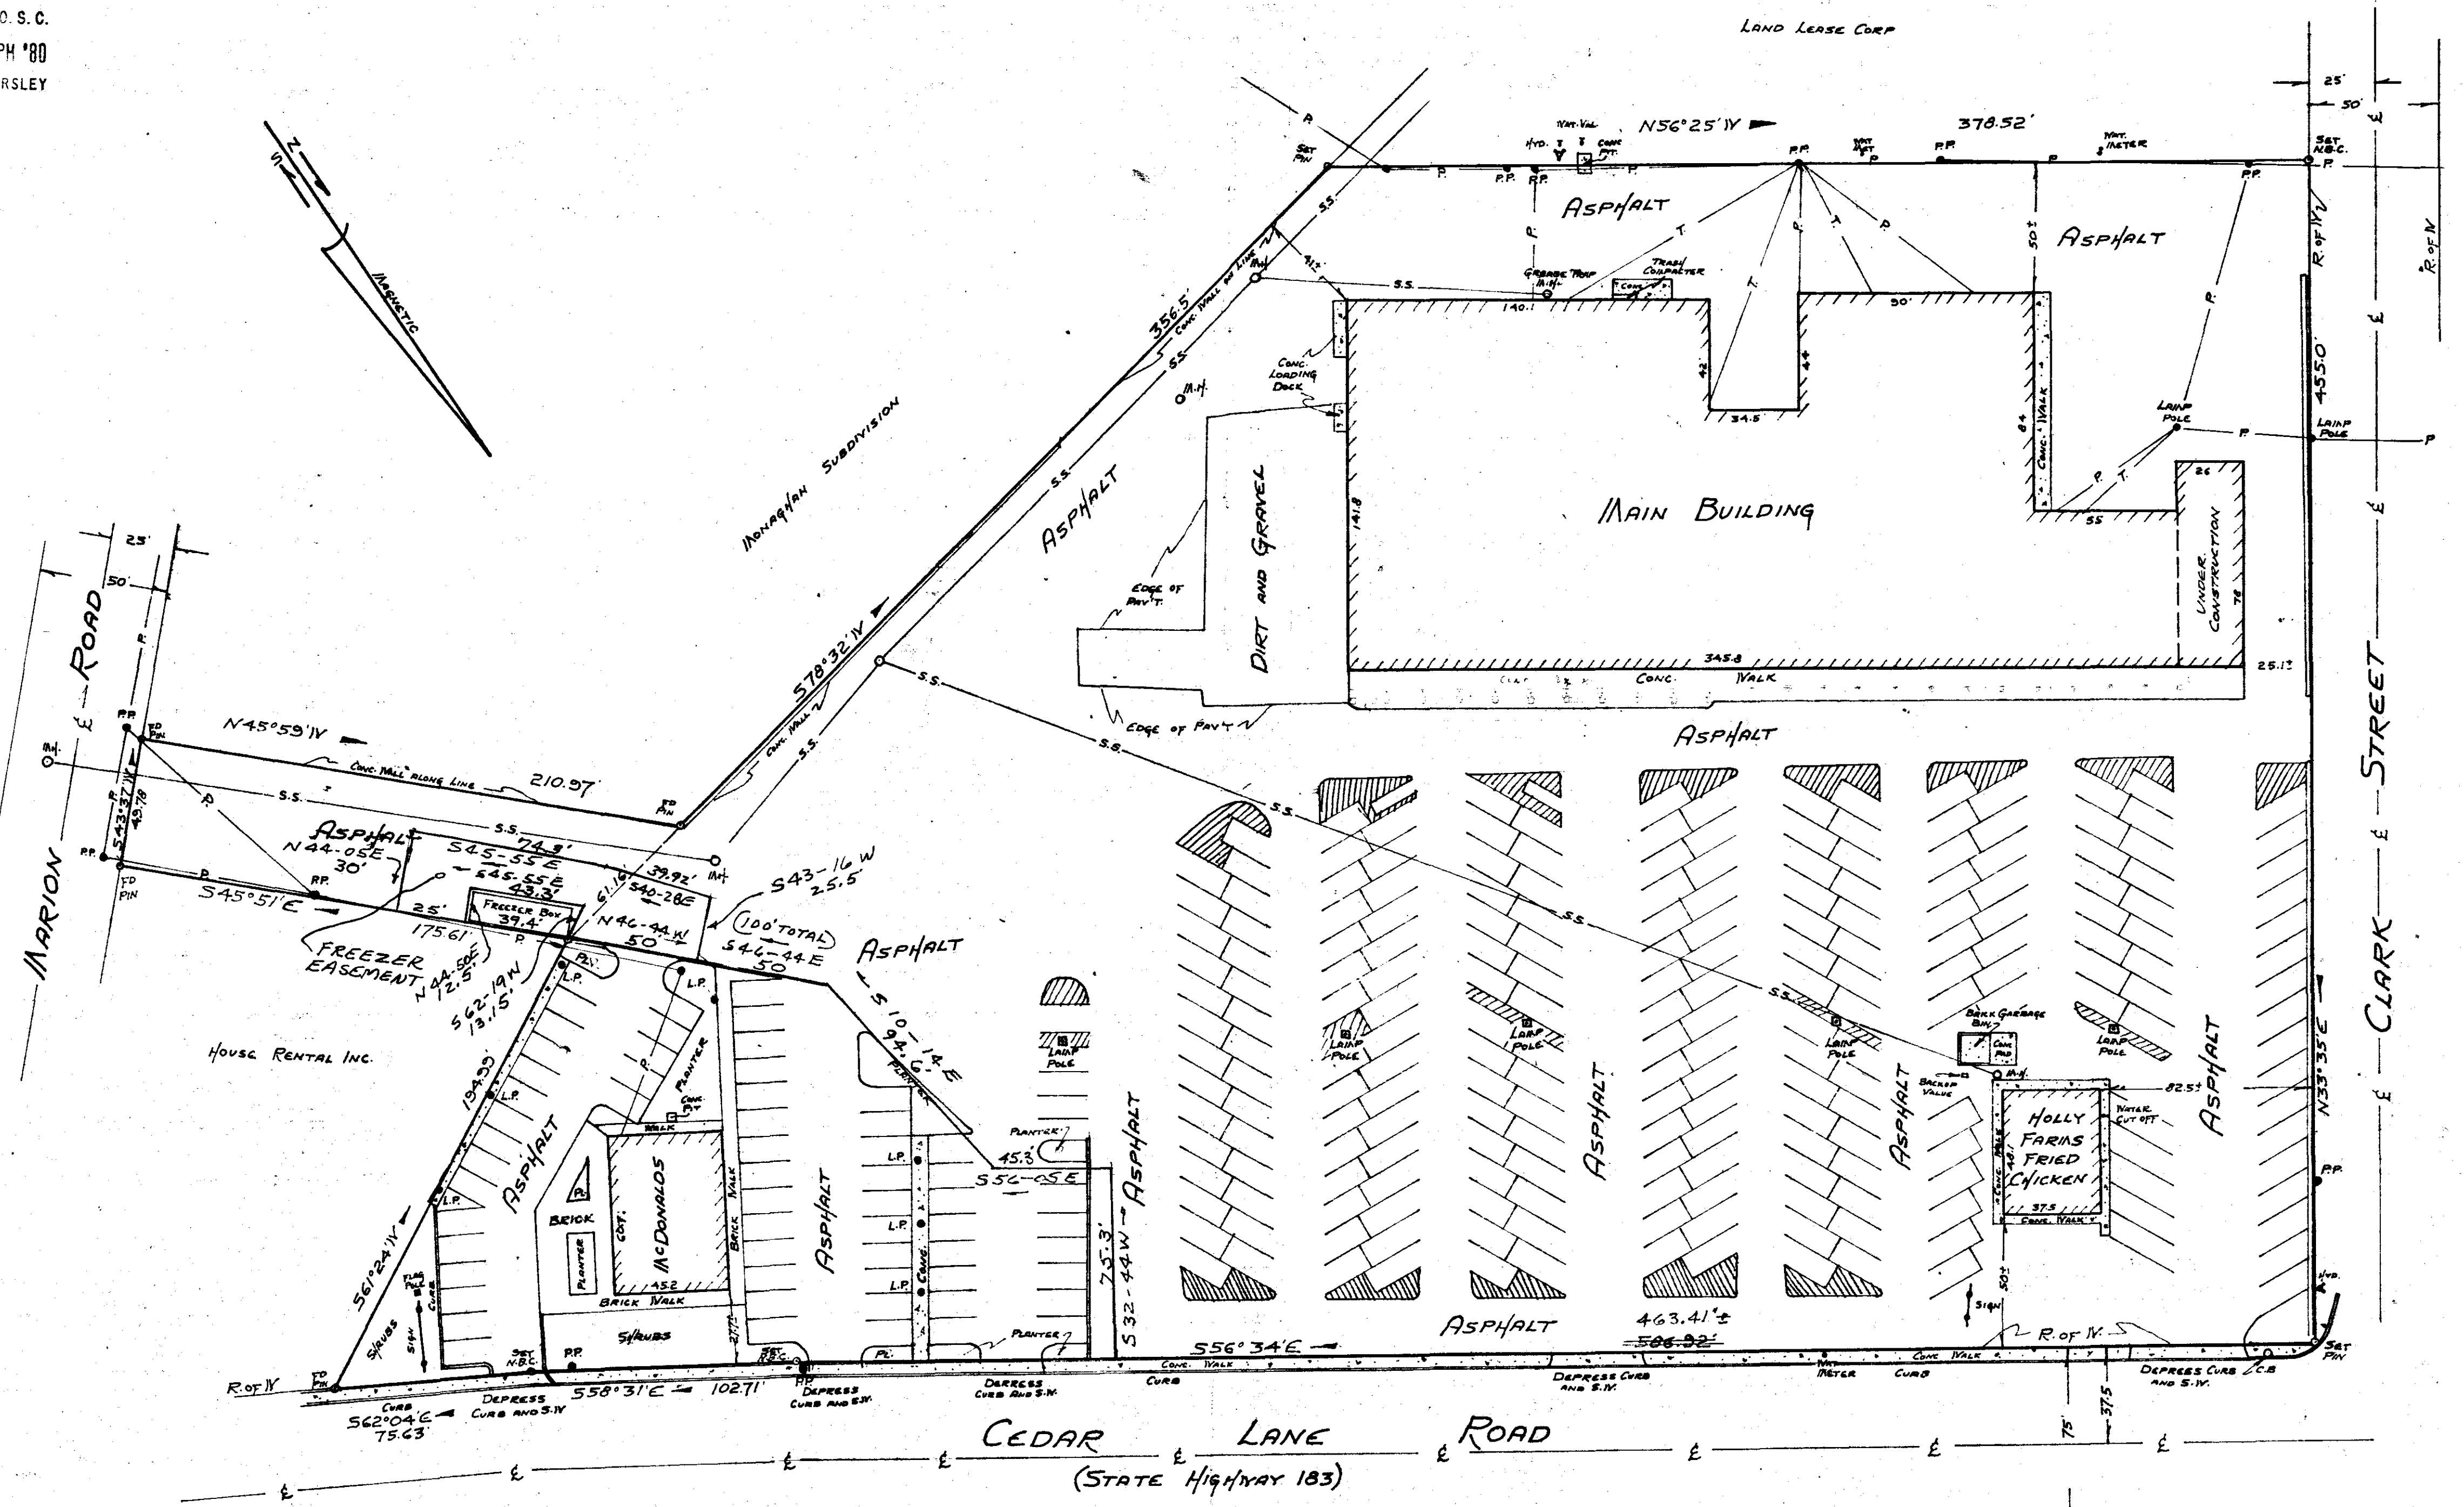


FILED
GREENVILLE CO. S.C.
AUG 5 2 03 PM '80
DONNIE WANKERSLEY
R.M.C.

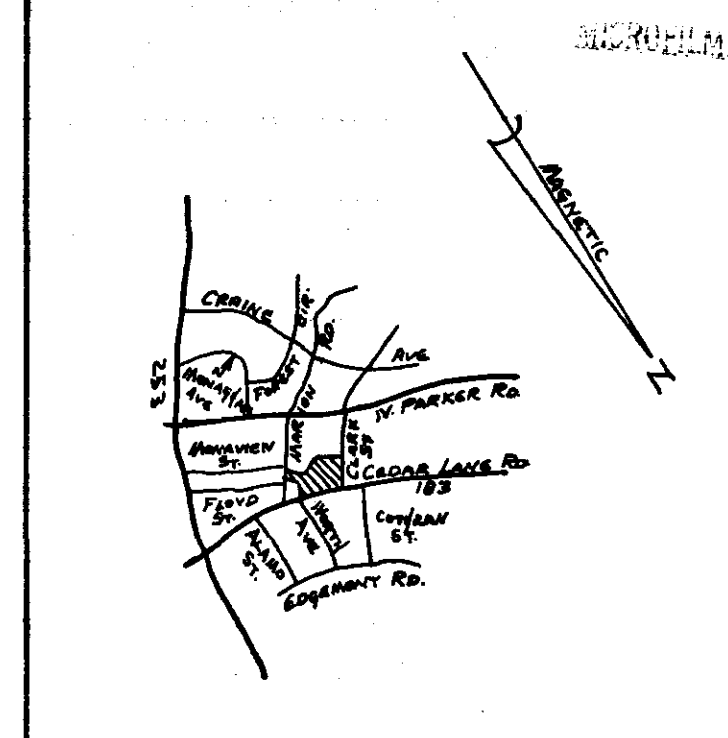

THIS PLAT IS A SUBDIVISION
A PLAT FOR GREENVILLE
COUNTY SOUTH CAROLINA.
8/5/76
Chief Clerk, Secretary, or Director of
Planning
Greenville County Planning Commission

FINAL AS BUILT SURVEY FOR
LAND LEASE CORP.
NEAR GREENVILLE, SOUTH CAROLINA
SCALE 1"=40' Nov. 16, 1976

NOTE:
TRACT FOR MCDONALDS CORPORATION ADDED
JUNE 23, 1980 - NO FIELD SURVEY MADE -
DESCRIPTION TAKEN FROM TOPOGRAPHICAL
MAP FOR MCDONALDS CORP. DATED MAY 1979
BY DALTON & NEEVES CO. ENGR. BEARINGS
CONVERTED TO SAME MAGNETIC DATUM
AS LAND LEASE PLAT.


3432 BY: CLARKSON SURVEYING
S.C. Clarkson SCRLS 2589

7-4-60

CERTIFICATE
THIS IS TO CERTIFY THAT ON NOV 16, 1976, I SURVEYED THE PROPERTY ON THIS
PLAT, AND THE SAME IS CORRECT, BEING THE SAME PROPERTY AS DESCRIBED IN
DEED RECORDED IN DEED BOOK 261 ON PAGE 656, OFFICE OF R.M.C. FOR GREENVILLE
COUNTY, SOUTH CAROLINA.
THAT THE DIMENSIONS OF THE NEW STRUCTURE ARE AS SHOWN ON SAID PLAT, AND
THE IMPROVEMENTS ARE WITHIN THE LOT LINES AND THAT NO RESTRICTIVE BUILDING
LINES HAVE BEEN VIOLATED.
THAT THERE ARE NO EASEMENTS OR ENCROACHMENTS OR UTILITIES CROSSING, EXCEPT
AS SHOWN HEREON.

R. D. Wankersley
REG. LAND SURVEYOR
NS 4678

7-4-61

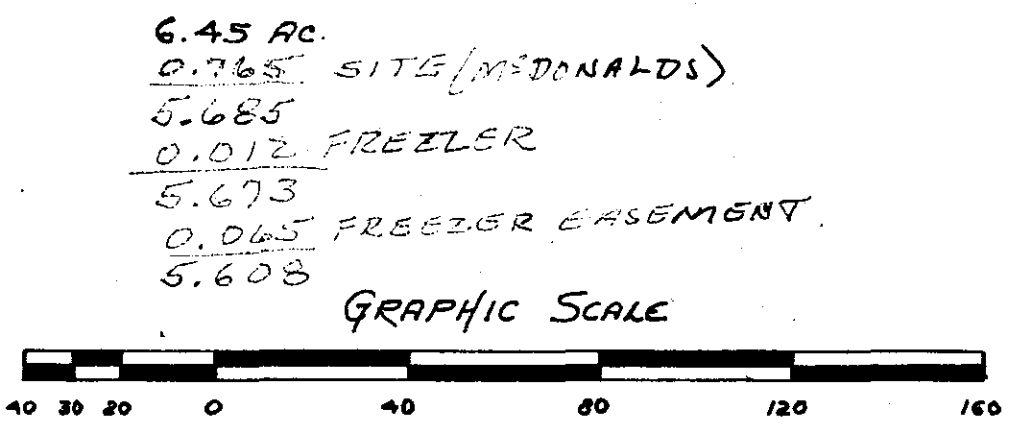

AUG 5 1980

BY CAMPBELL & CLARKSON
SURVEYORS, INC.

R. D. Wankersley
SCRLS NS 4678

50701
50702
50703
50800