


FILED
 GREENVILLE CO. S. C.
 JUN 7 2 13 PM '83
 DONNIE S. TANKERSLEY
 R.M.C.

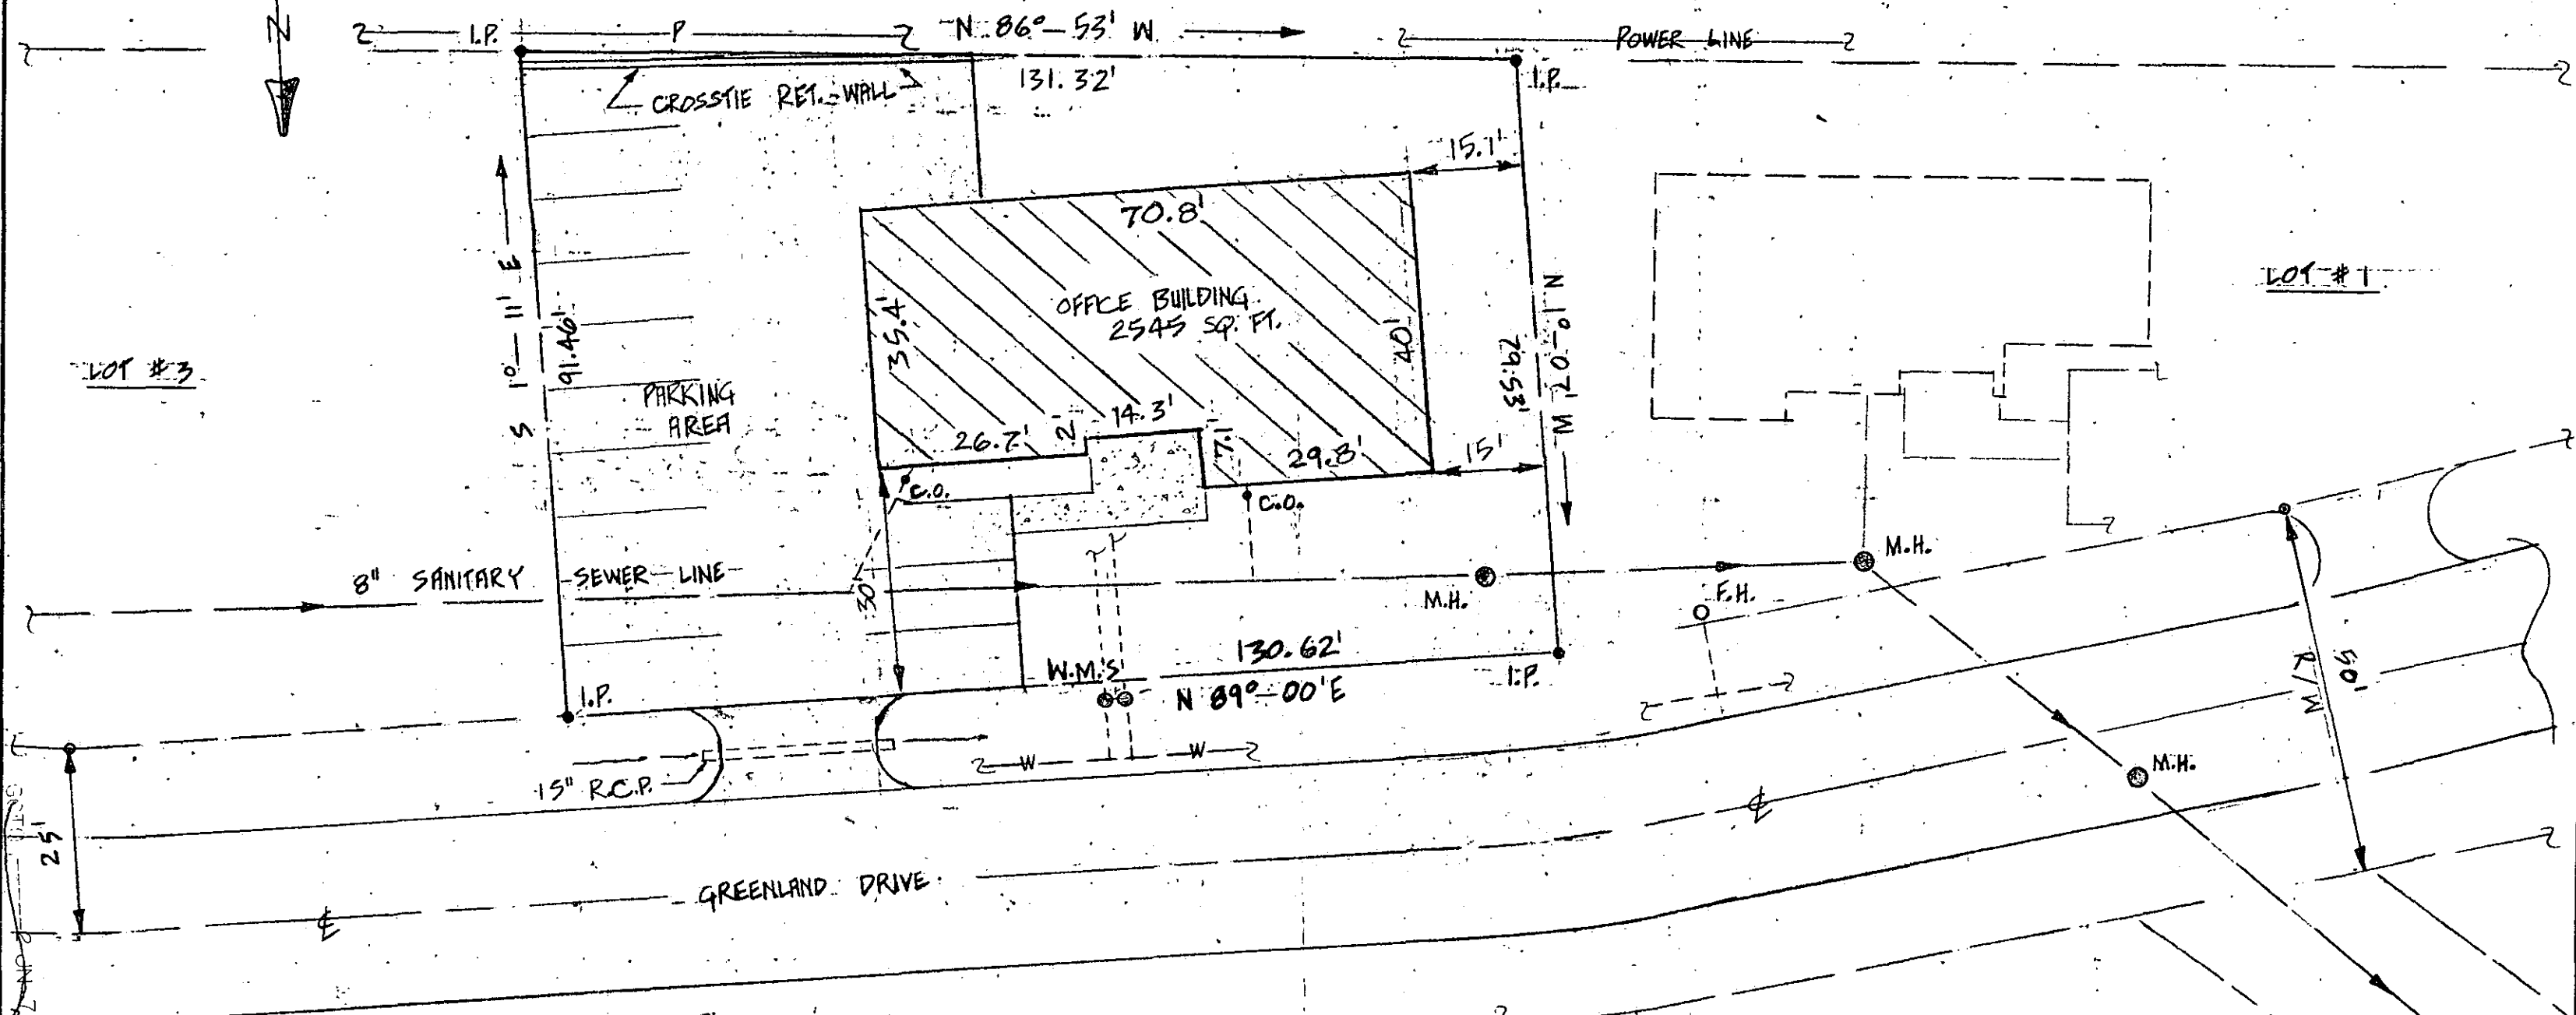

NOTES:

- "AS-BUILT" SURVEY MADE, 5-20-83. OFFICE BUILDING, ALL UTILITIES/SERVICES LOCATED IN FIELD AS SHOWN. PARKING AREA, OTHER IMPROVEMENTS SHOWN AS DESIGNED.
- 5' EASEMENT, EACH SIDE AND REAR LOT LINE.
- # OF PARKING SPACES ALLOTTED: 13 @ 8'-6" 1 @ 12'-0"


JUN 7 1983

33118

9-R-54

I CERTIFY THAT THIS LOT HAS BEEN SURVEYED AND IS, TO THE BEST OF MY KNOWLEDGE, AS SHOWN ABOVE; THAT THERE ARE NO ENCROACHMENTS; AND THAT THIS LOT IS NOT IN A FLOOD PLAIN.

Kermit J. Gould
 KERMIT J. GOULD / SC R.O.S. 4033

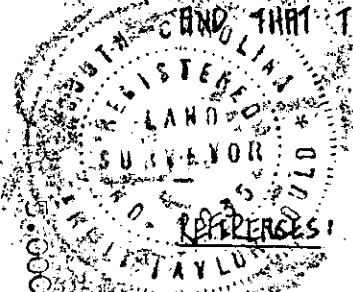

REFERENCES: DEED VOL. 1161, PG. 26; PLAT BK. 62, PG. 52/7X, PG. 69; BLOCK BOOK SH. (12) - 519-280-1-5.23.

PROPERTY OF: W. WILLIAM BASHOR, JR. JOHN F. PALMER	
LOT # 2 "GREENLAND CROSSING"	SCALE 1" = 20'
DATE 5-20-83	DRAWN BY K. GOULD, JR. REVISED
APPROVED BY	DRAWING NUMBER

169

5-20-83

MICROFILMED