
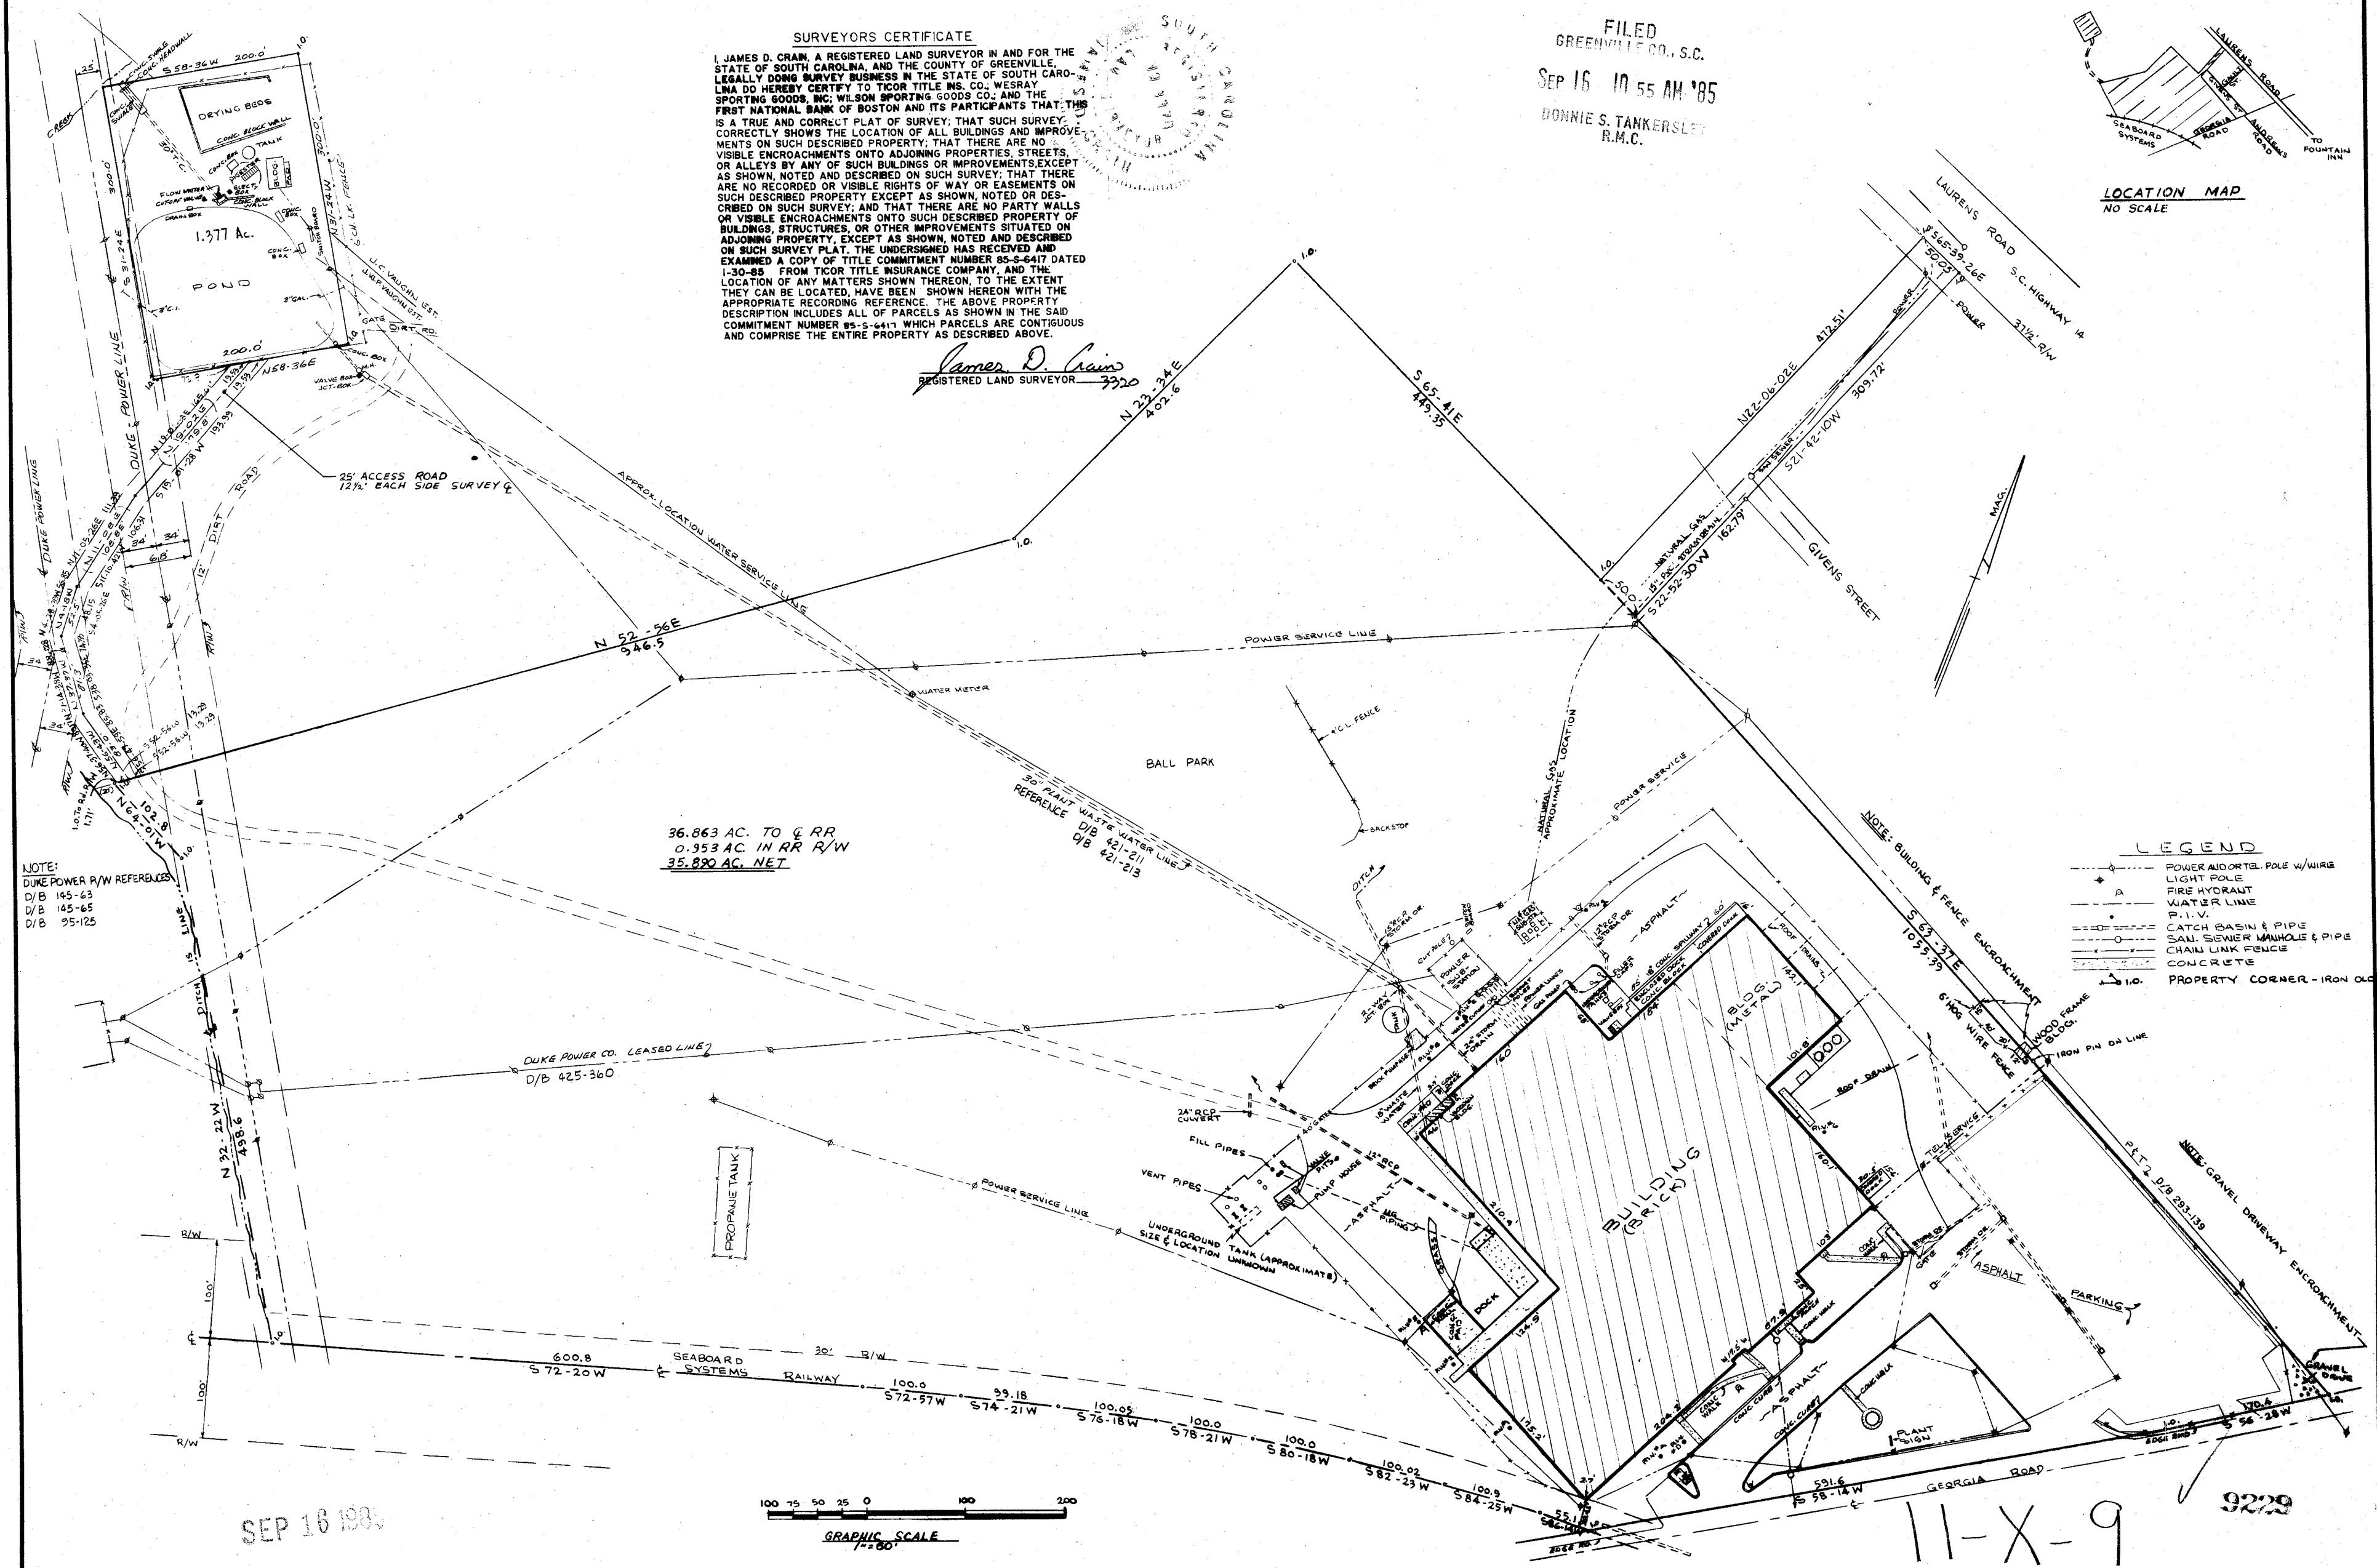


SURVEYORS CERTIFICATE

I, JAMES D. CRAM, A REGISTERED LAND SURVEYOR IN AND FOR THE STATE OF SOUTH CAROLINA, AND THE COUNTY OF GREENVILLE, LEGALLY DOING SURVEY BUSINESS IN THE STATE OF SOUTH CAROLINA DO HEREBY CERTIFY TO TICOR TITLE INS. CO., WESRAY SPORTING GOODS, INC., WILSON SPORTING GOODS CO., AND THE FIRST NATIONAL BANK OF BOSTON AND ITS PARTICIPANTS THAT THIS IS A TRUE AND CORRECT PLAT OF SURVEY...


James D. Cram REGISTERED LAND SURVEYOR 3320

FILED GREENVILLE CO., S.C. SEP 16 10 55 AM '85 DONNIE S. TANKERSLEY R.M.C.

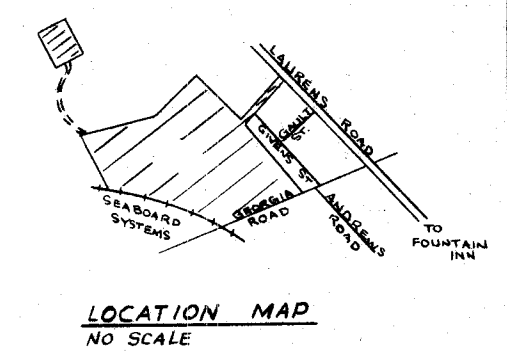


NOTE: DUKE POWER R/W REFERENCES D/B 193-63 D/B 145-45 D/B 95-125

36.863 AC. TO G RR 0.953 AC. IN RR R/W 35.890 AC. NET

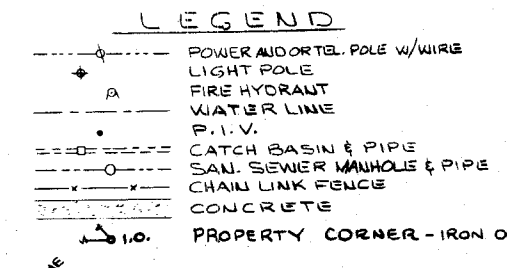

SEP 16 1985

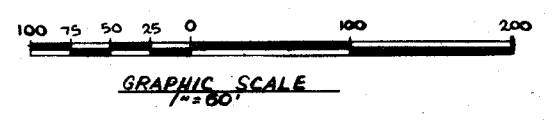

11-X-9 9229

Table with columns: NO., DATE, REVISION, BY, NO., DATE, REVISION, BY. Includes a revision record for 9-11-85.

PIEDMONT ENGINEERS • ARCHITECTS • PLANNERS 480 PARK AVENUE • GREENVILLE, SOUTH CAROLINA 29608



PROPERTY OF WILSON SPORTING GOODS CO. A DELAWARE CORPORATION FOUNTAIN INN, S.C. AS-BUILT SURVEY



Table with columns: PROJ. NO., DRAWING NO., DRAWN, CHECKED, APPROVED, DATE, JOB NO., LAST REV. NO., DATE REV.