


FILED  
GREENVILLE CO.

MAY 26 3 02 PM


OLLIE FARNSWORTH  
R. M.C.

PRANCER AVENUE

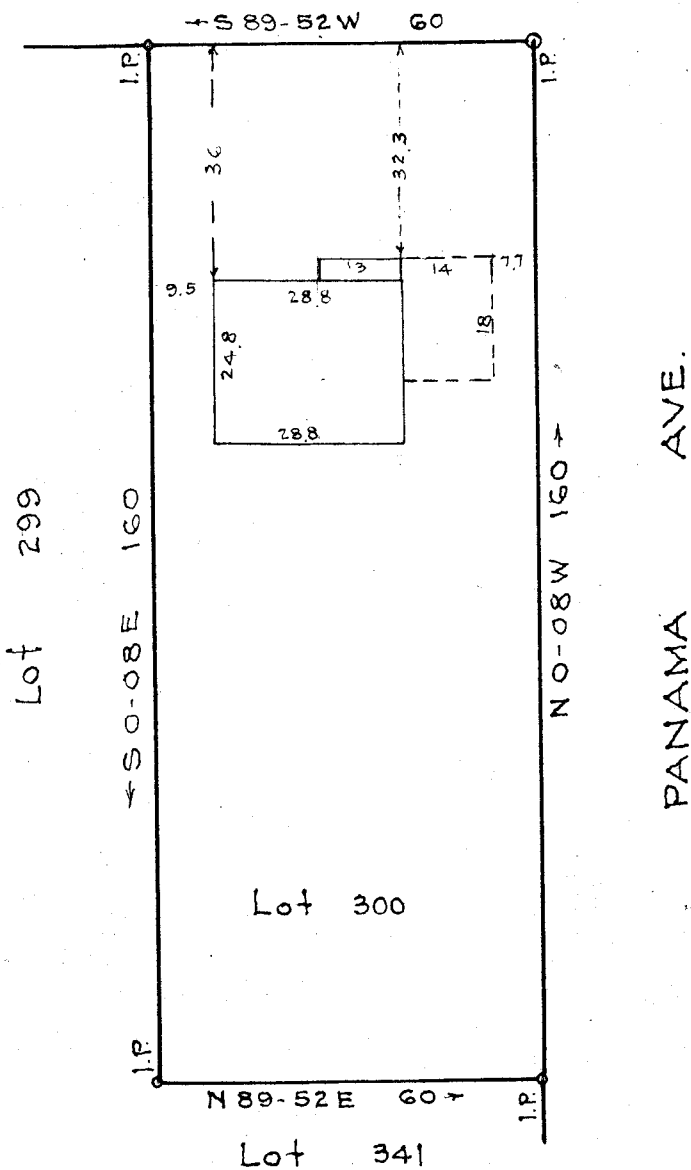

MAY 26 1950  
13043

PROPERTY OF  
FRANCIS R. GOSSETT  
GREENVILLE S. C.  
Scale 1" = 30' May 1950

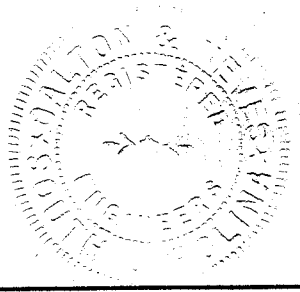

#13043 ~~FILED~~ ~~MAY 26 1950~~ May 26 1950  
 And Recorded in Vol. 7 Page 187 at 3:00  
 Ollie Farnsworth  
 Register Mesne Conveyance Greenville County, S. C.