FILED
GREENVILLE CO. S. C.
DEC 9 4 42 PM 1964
OLLIE FARNSWORTH
R. M.C.

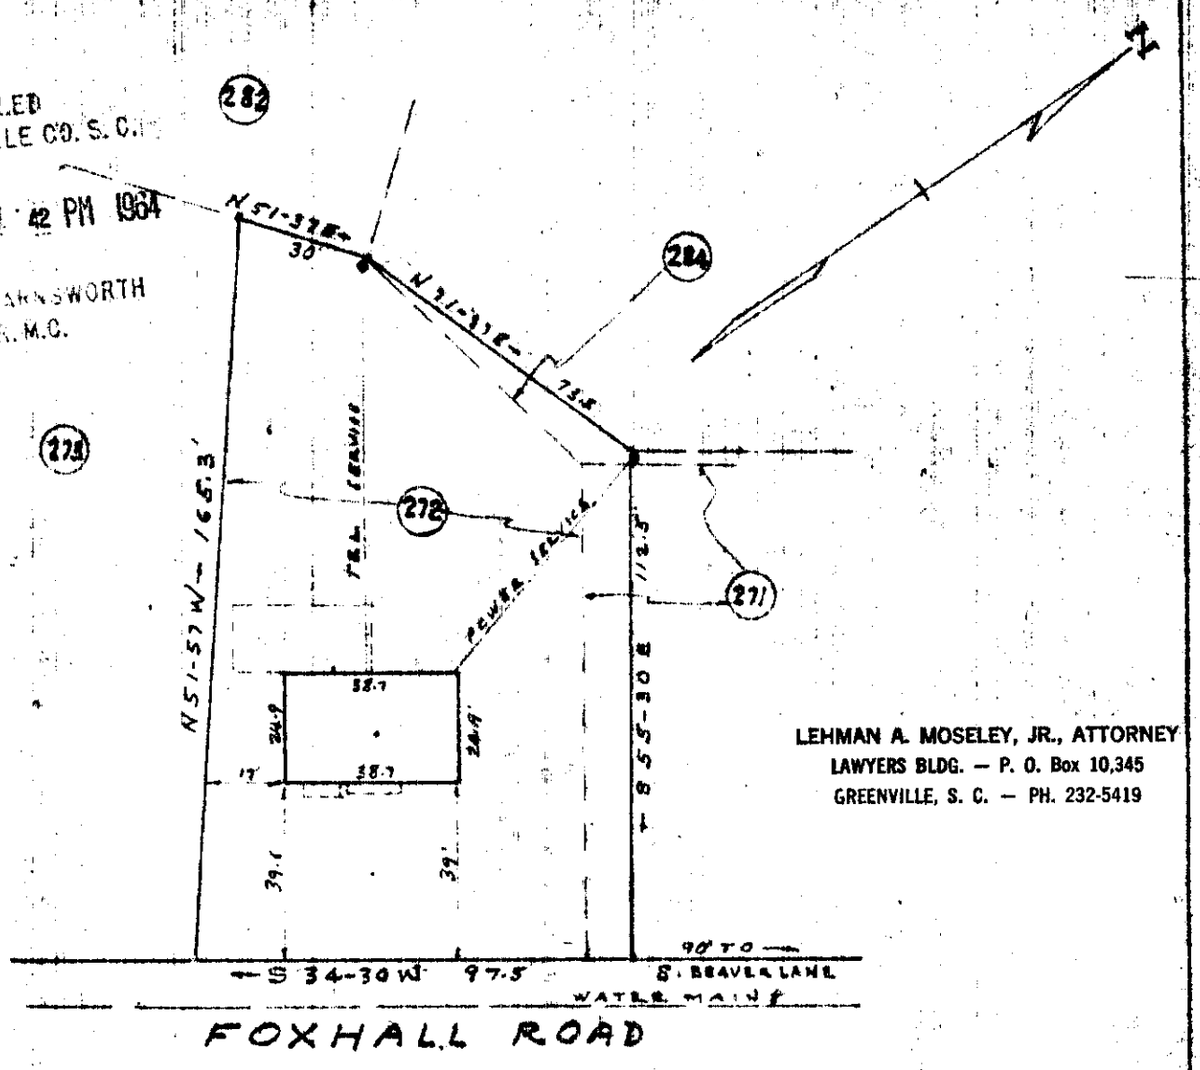

LEHMAN A. MOSELEY, JR., ATTORNEY
LAWYERS BLDG. — P. O. Box 10,345
GREENVILLE, S. C. — PH. 232-5419

This is to certify that on Dec. 3, 1964, I surveyed the property shown on this plat, being known as a portion of Lot Nos. 271 & 284 and all of Lot No. 272, on plat of Section B Woodfields, filed in the R.M.C.Office for Greenville Co. in Plat Book Z at page 121, and that the property lines, walls and building are as shown hereon; that the building located on said lot does not encroach or project on adjacent streets or property, and that no adjacent walls or buildings encroach or project on said premises, and that no utility lines cross this property except as shown hereon.

Surveyed by RK Campbell

S.C.Reg. No. 996

16612

50

DEC 9 1964

PROPERTY OF
EDGAR J. TAYLOR
AND
RUTHIE H. TAYLOR
NEAR GREENVILLE S.C.
SCALE 1" = 40' DEC. 3, 1964

~~1111~~ - 50

16617 Filed This 9 day of Dec. 19 64
And Recorded in Vol. ~~1111~~ Page 50 at ..... M
Register Mesne Conveyance Greenville County, S. C.